



**DRAWING DISCLAIMER:**  
 THE DRAWING AND ALL INFORMATION CONTAINED HEREIN IS AUTHORIZED FOR USE ONLY BY THE PARTY FOR WHOM THE SURVEY WAS CONDUCTED AND IS NOT TO BE REPRODUCED, COPIED, DISTRIBUTED OR USED FOR ANY OTHER PURPOSE WITHOUT THE WRITTEN CONSENT OF LAND-TECH SERVICES, LLC.

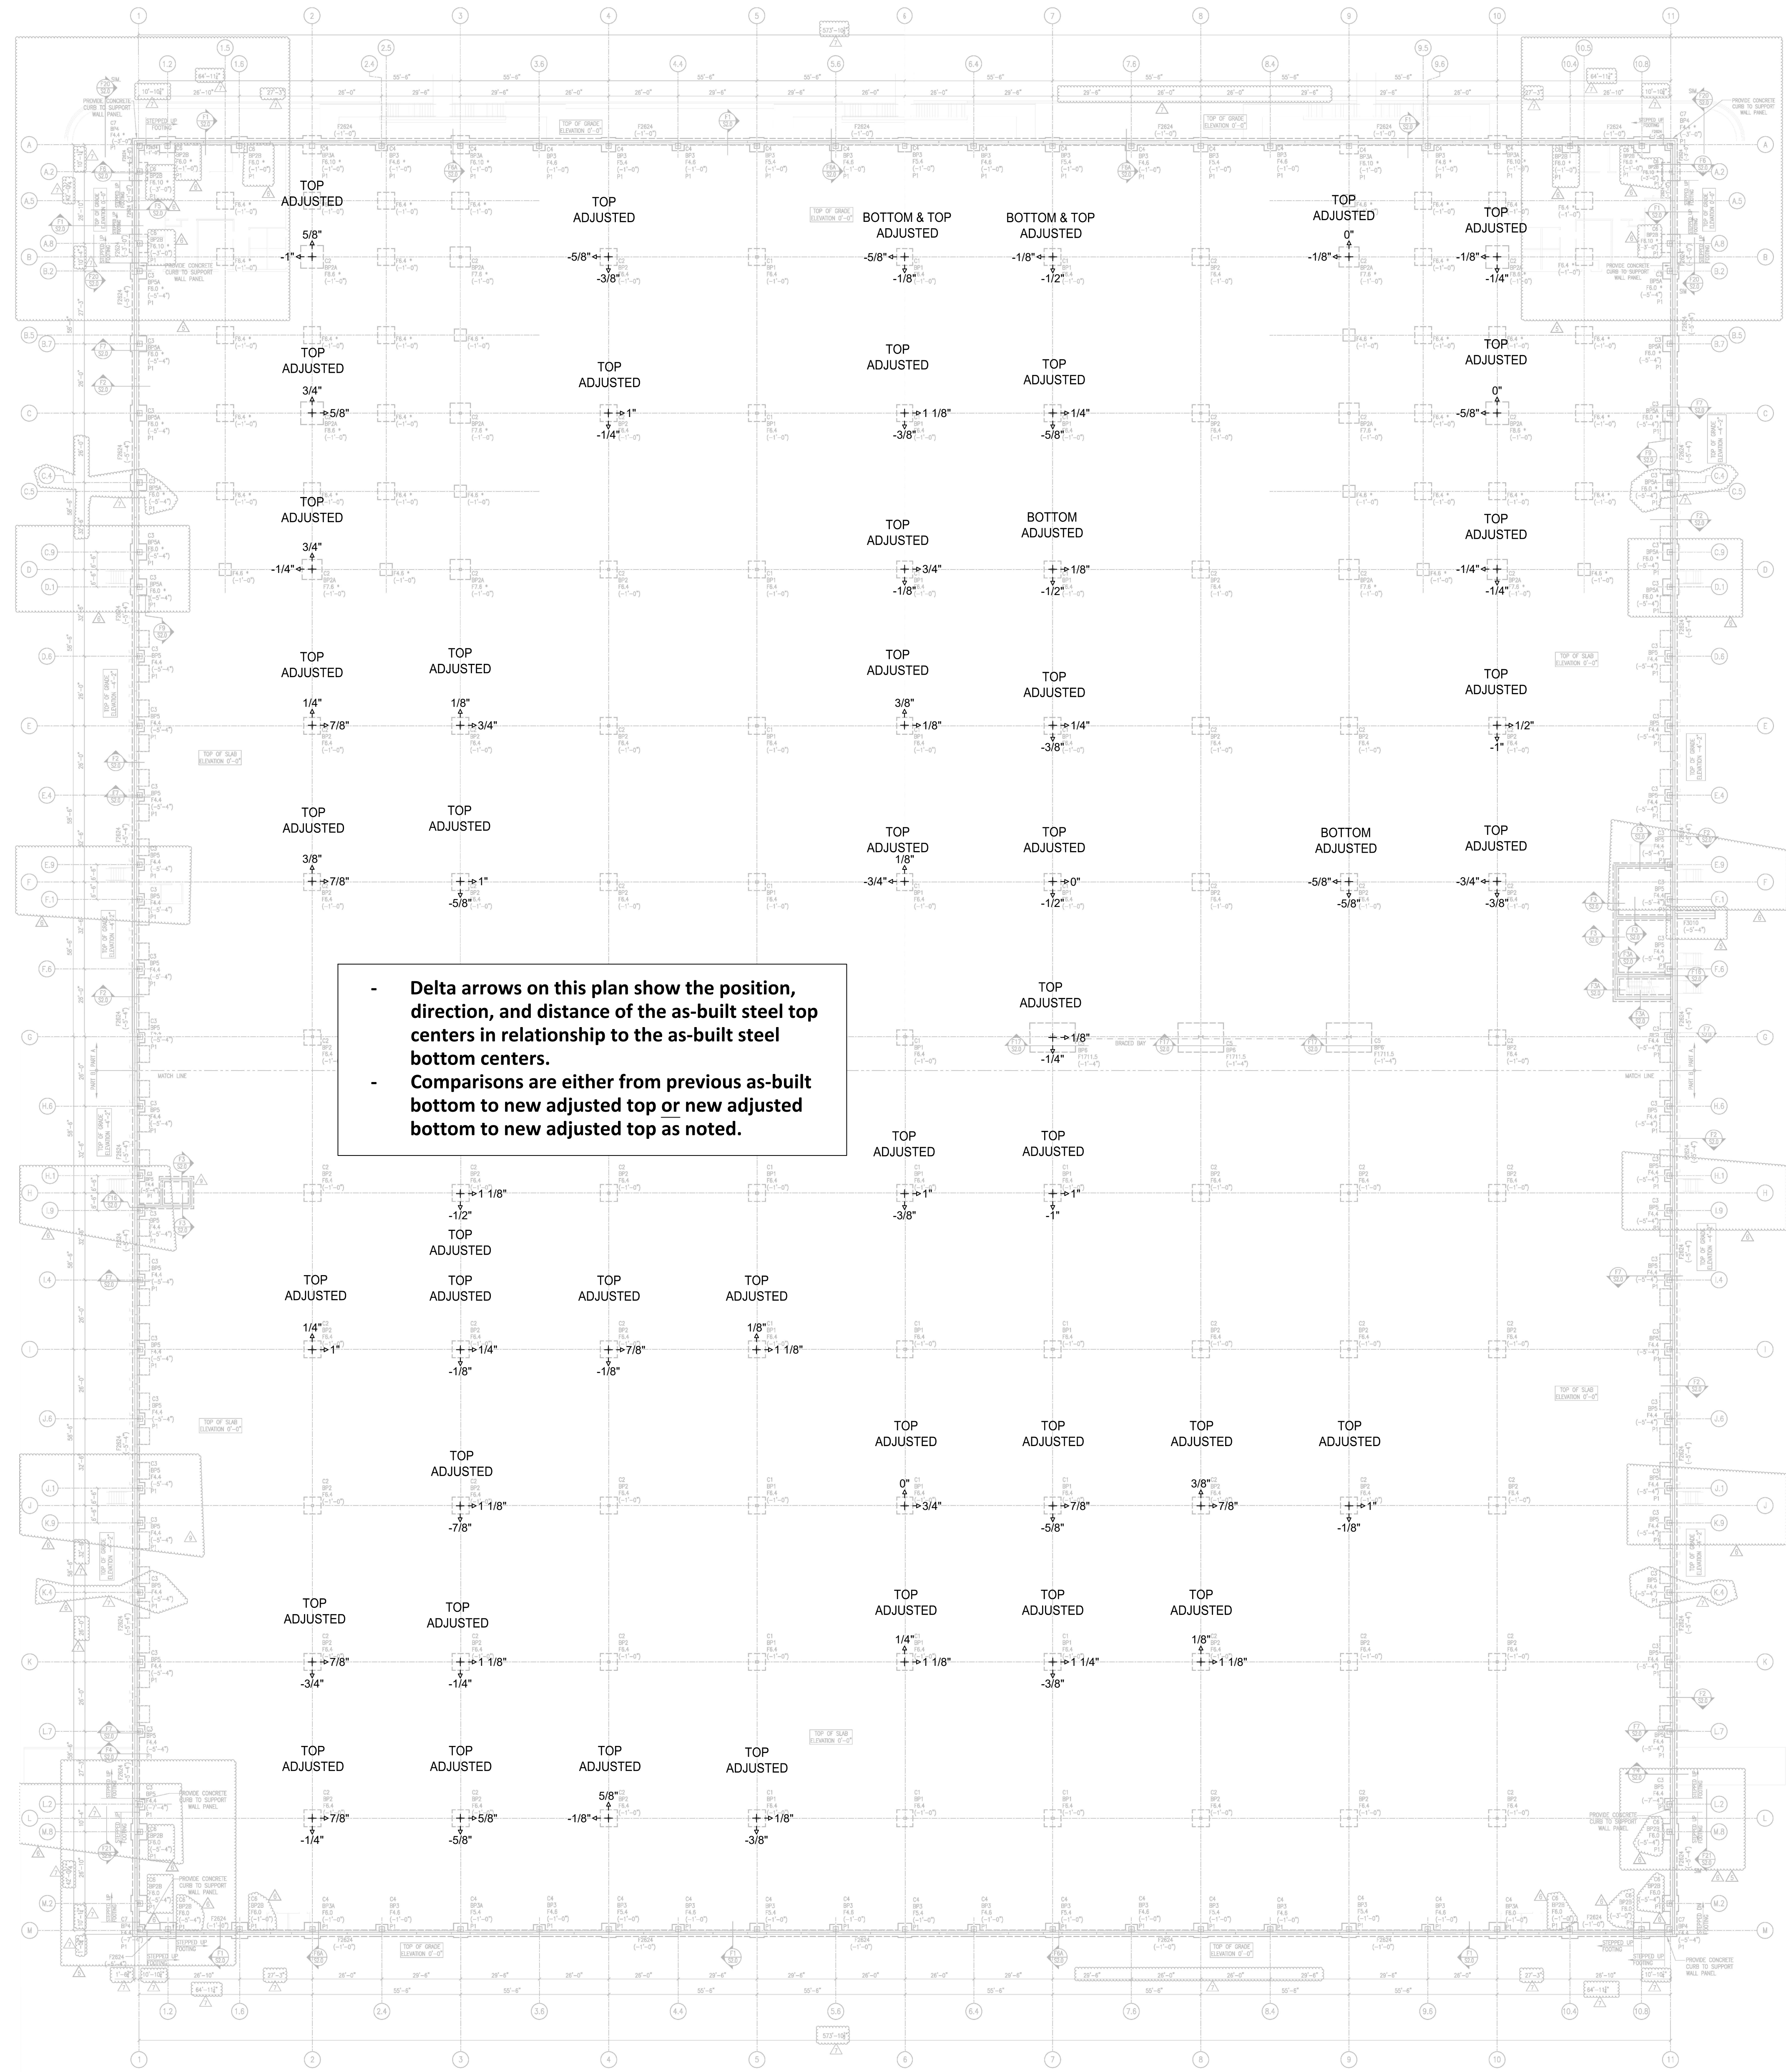


- Delta arrows on this plan show the position, direction, and distance of the as-built steel top centers in relationship to the as-built steel bottom centers.  
 - Comparisons are either from previous as-built bottom to new adjusted top or new adjusted bottom to new adjusted top as noted.

- NOTES:**
1. The intent of this plan is to depict the as-built anchor bolt locations for the noted building and project.
  2. This plan is only to report as-built conditions and does not guarantee compliance with contract specifications.
  3. Plan is based upon field work of Land-Tech Services on April 19, 26, 28 & May 11 2023.
  4. The background plan shown is titled 'PARTIAL FOUNDATION PLAN' prepared by Mistry Design with a revision date of 11/18/2022 and is for reference only.
  5. This plan does not depict any bowing or deformation in the steel, only the location and dimensions of the tops and bottoms of the columns.
  6. As built top and bottom center of steel locations based upon observations taken on the face of columns and offset to the centers.
  7. Design column lines were reestablished based upon as-built center location of columns Dx6 and Jx6, shown as within tolerance on "Anchor Bolt As-Built Plan" prepared by MidAtlantic Engineering Partners, LLC and dated 11/27/2022.
  8. Delta arrows show the position, direction, and distance of the as-built steel top centers in relationship to the as-built steel bottom centers.

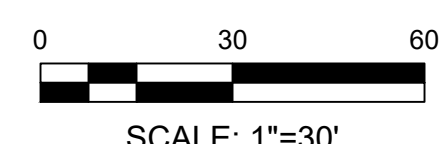

NO.	DATE	REVISIONS	DRWN BY	CHK BY
1				

ADJUSTED STEEL AS-BUILT SURVEY		 LAND-TECH SERVICES, LLC 413 Briarwood Road Marlton, NJ 08053 Certificate of Authorization PEA2309100 www.land-tech.com 608-685-1424	ADAM R. VOIGT PROFESSIONAL LAND SURVEYOR NEW JERSEY LICENSE #24G504343200 DATE:			
ADJUSTED STEEL PLUMBNESS DELTAS Heller Park North Building No. 4 20 Sagle Lane Township of South Brunswick Middlesex County, New Jersey						
DATE: 5/11/23	FIELD: EV	DRAWN: EV	CHECKED: AV	JOB NO. 23-030	SCALE: 1"=30'	SHEET 1 OF 1