

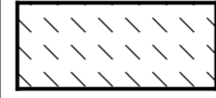

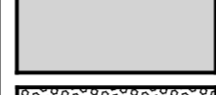
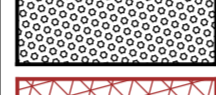
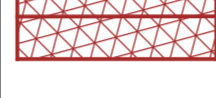



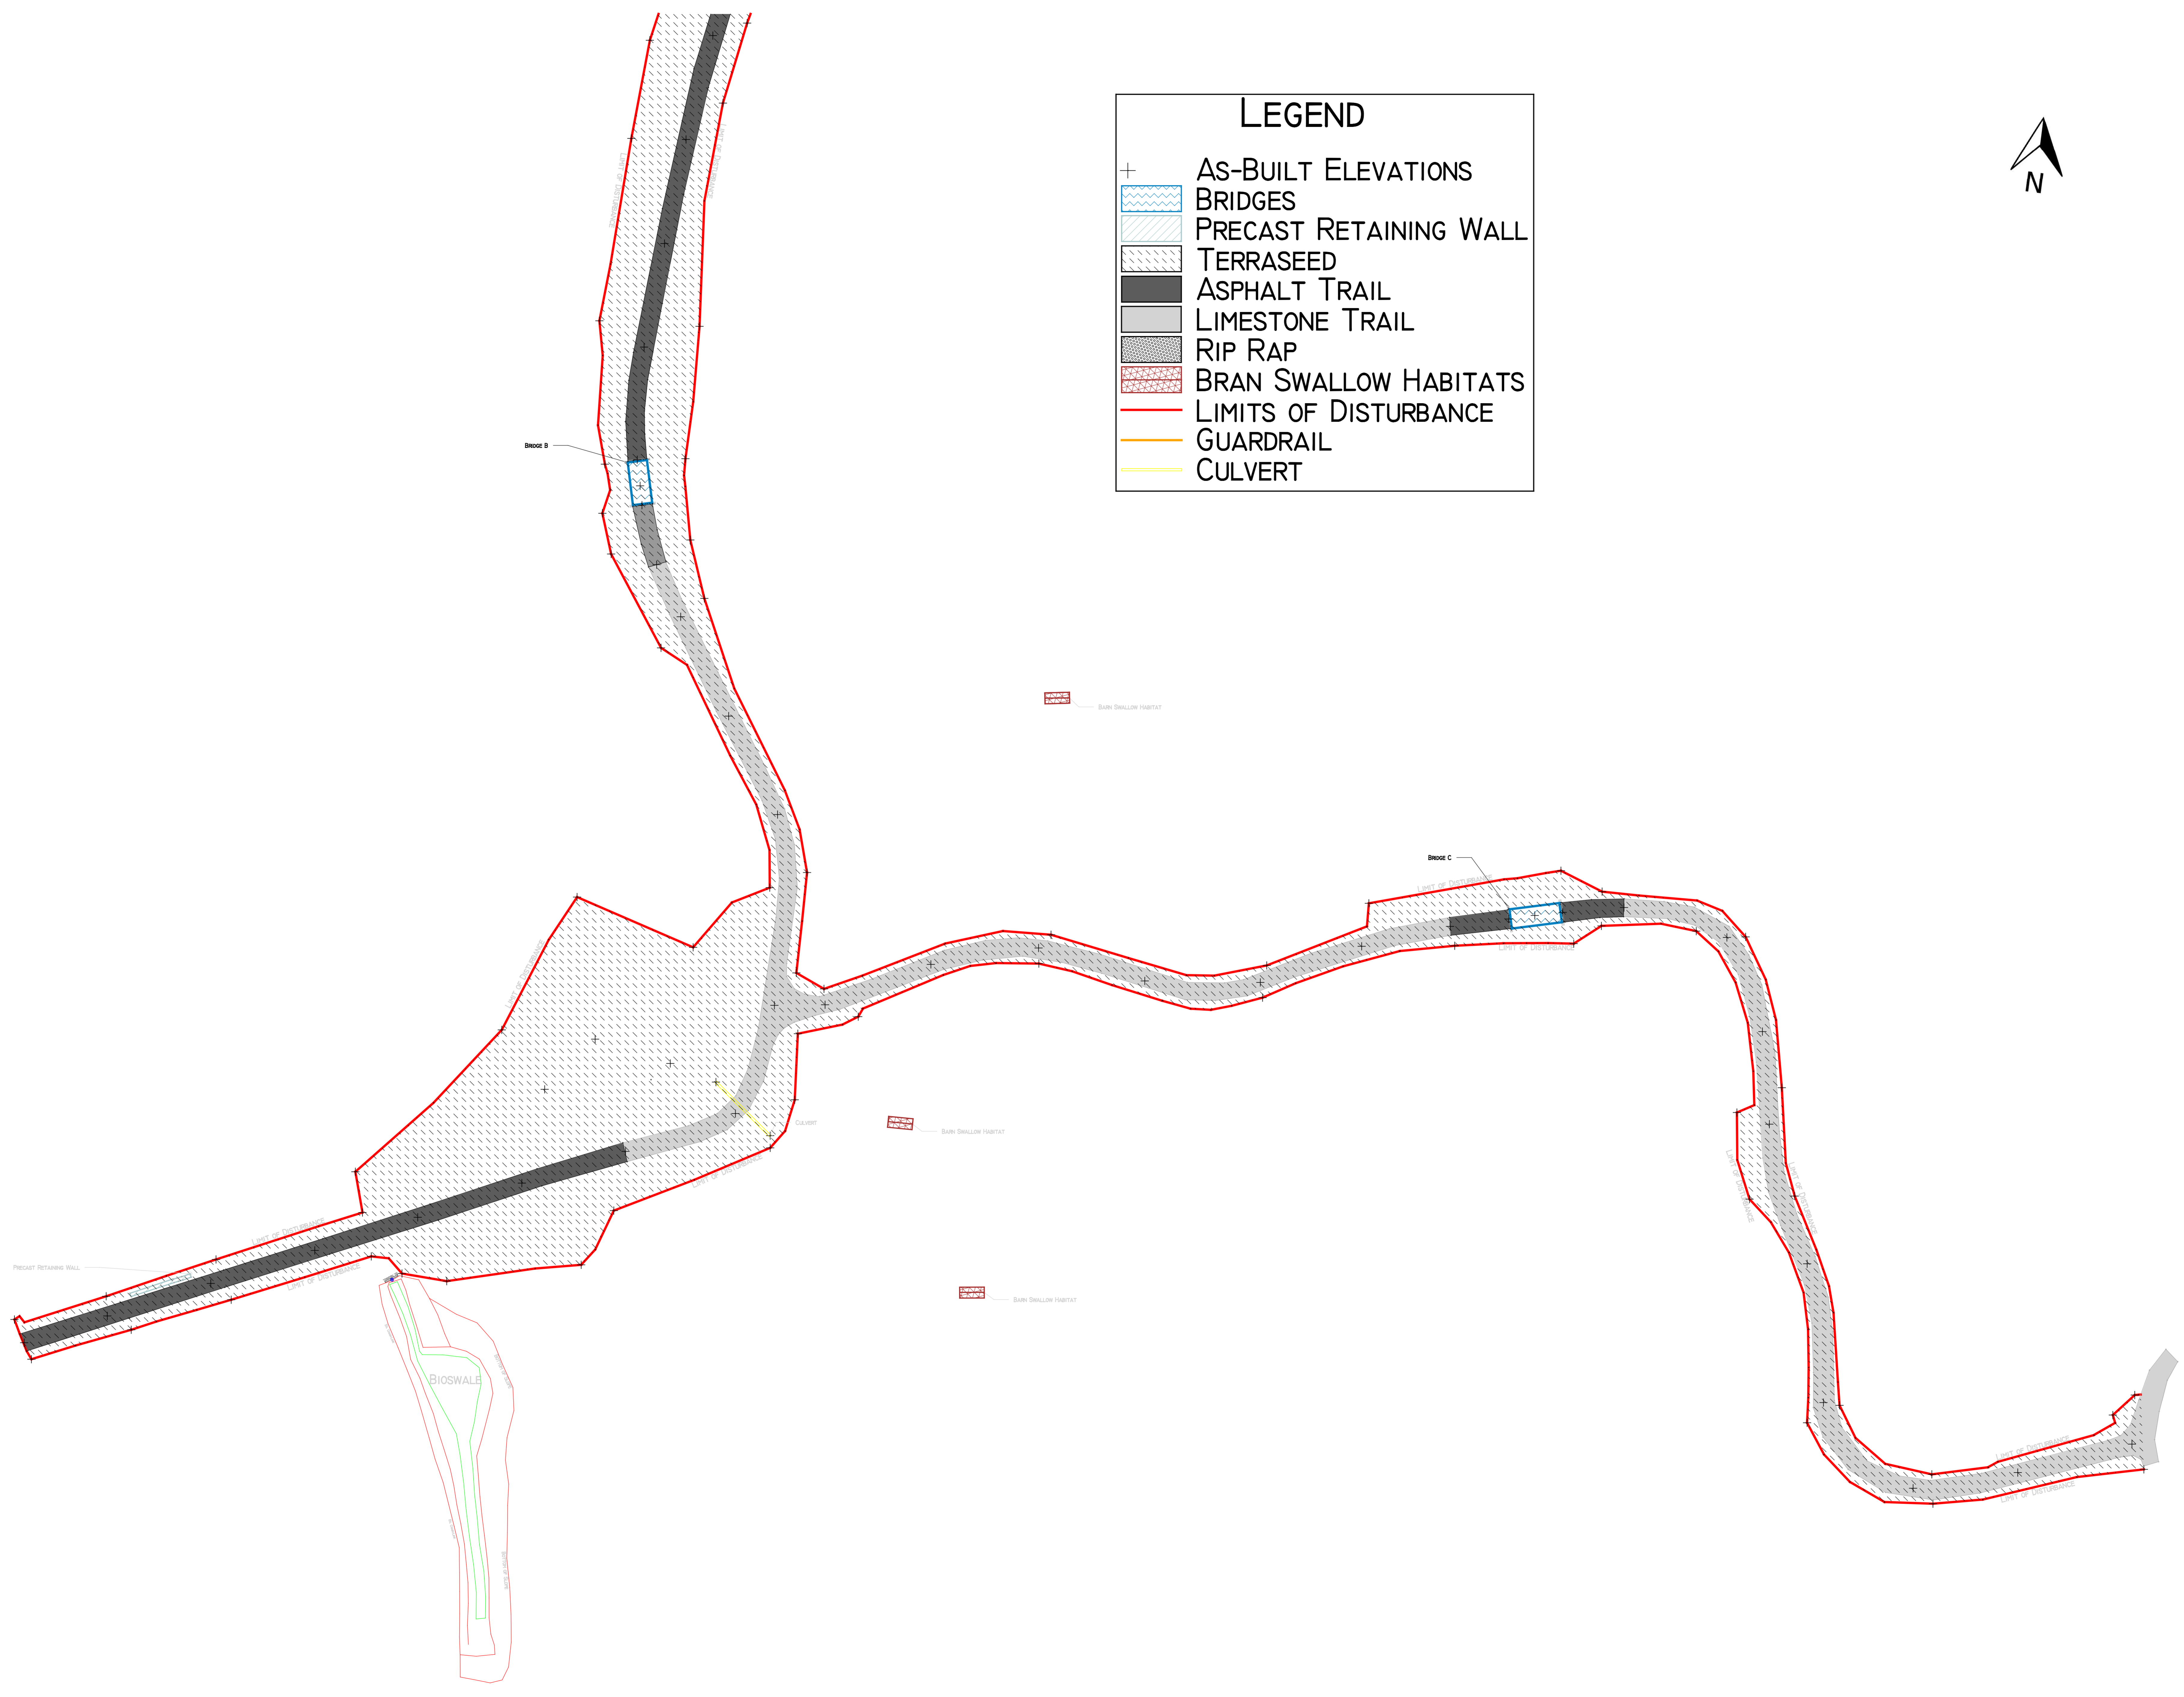


### LEGEND

- + AS-BUILT ELEVATIONS
-  BRIDGES
-  PRECAST RETAINING WALL
-  TERRASEED
-  ASPHALT TRAIL
-  LIMESTONE TRAIL
-  RIP RAP
-  BRAN SWALLOW HABITATS
-  LIMITS OF DISTURBANCE
-  GUARDRAIL
-  CULVERT



Test

test

Test

test

--	--	--