


# LEGEND

- EXISTING GROUND BREAKLINE
- BIOSWALE AREA BOUNDARY
- + 234.00 EXISTING GROUND ELEVATIONS
- + 234.00 BIOSWALE AS-BUILT ELEVATIONS
- ⊗ INVERT =234.40 M



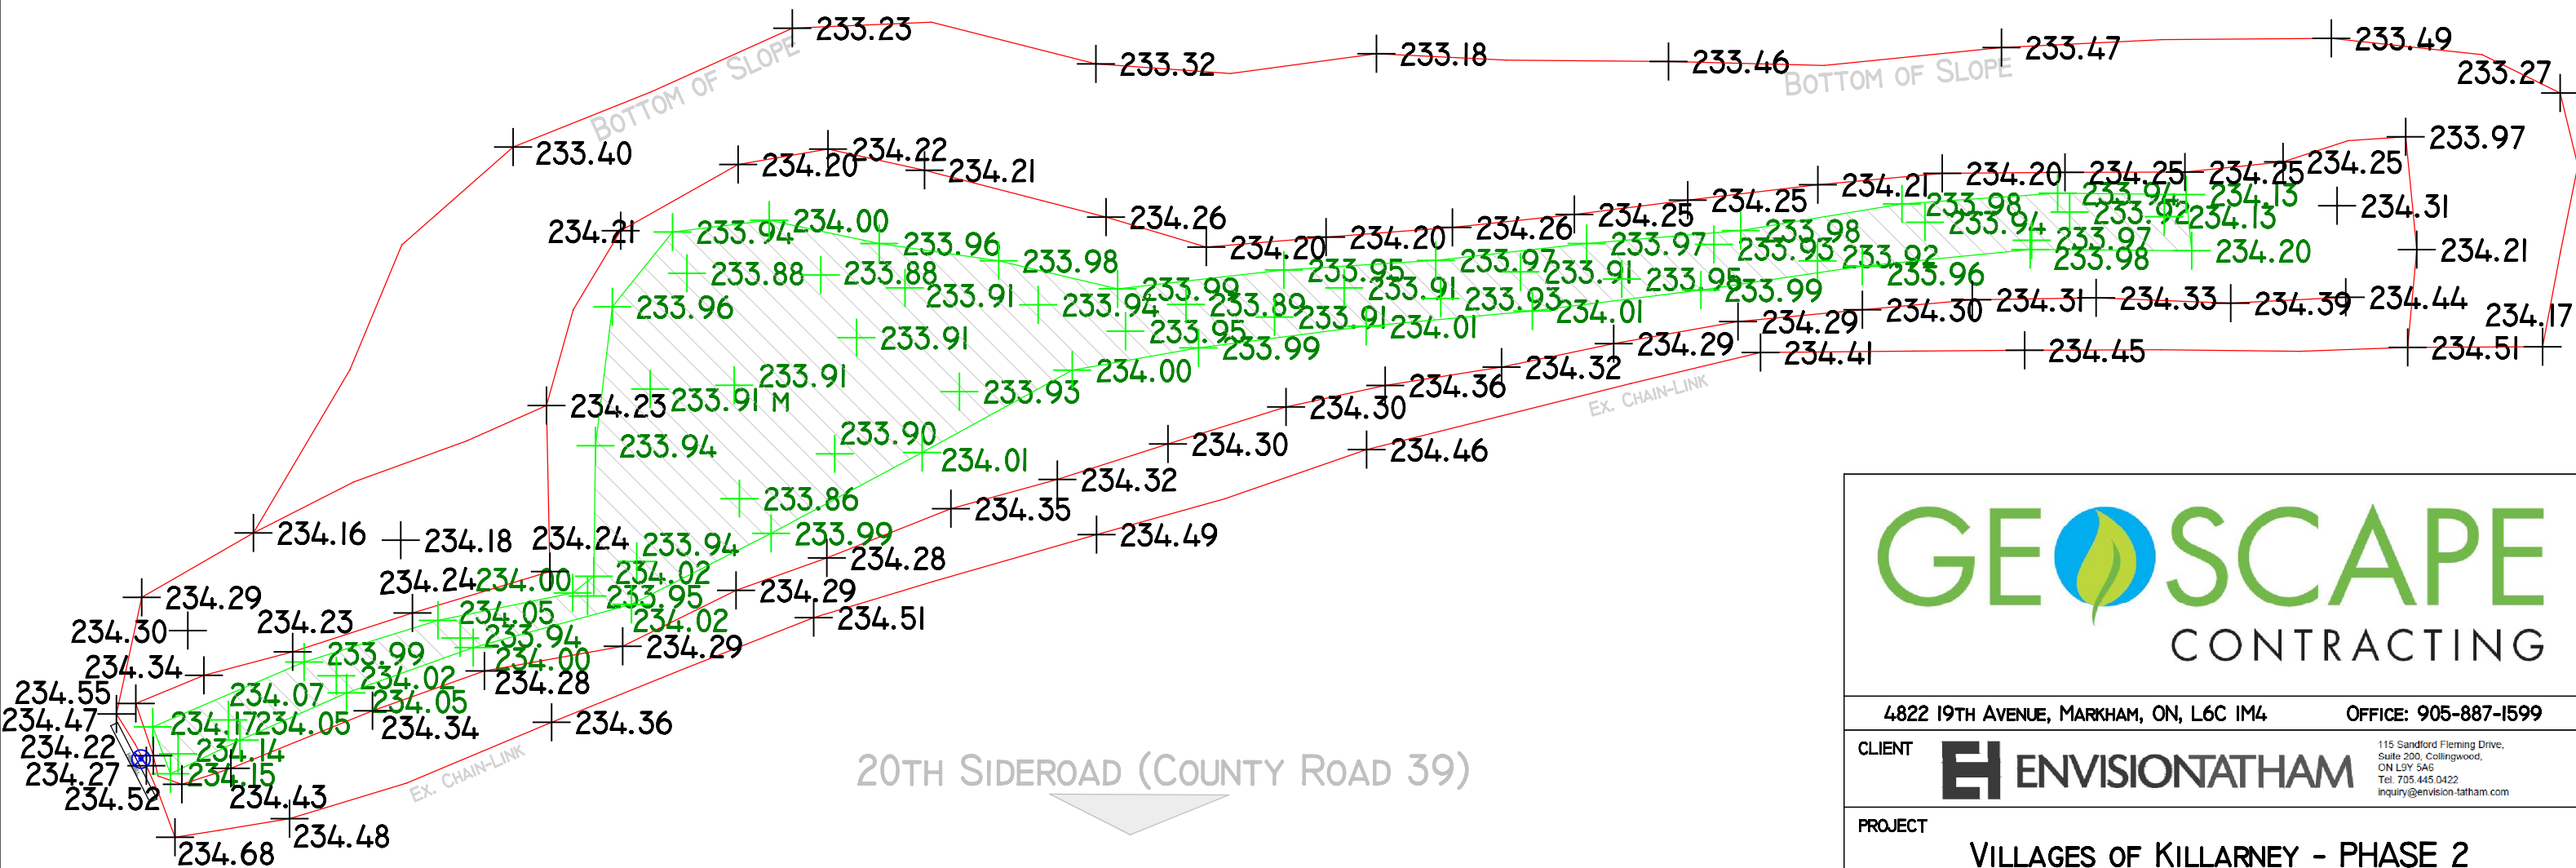

**GEOSCAPE**  
CONTRACTING

4822 19TH AVENUE, MARKHAM, ON, L6C 1M4      OFFICE: 905-887-1599

CLIENT **ENVISIONATHAM**  
115 Sandford Fleming Drive,  
 Suite 200, Collingwood,  
 ON L9Y 5A6  
 Tel. 705.445.0422  
 inquiry@envision-tatham.com

PROJECT **VILLAGES OF KILLARNEY - PHASE 2**

SHEET TITLE **BIOSWALE TOPOGRAPHIC SURVEY  
(AS-BUILT) POST-MEDIA GRADING**

COORDINATE SYSTEM **WORLD GEODETIC SYSTEM - WGS 1984**

SCALE <b>1:135</b>	SURVEYED BY <b>JOHN CONNOR</b>	PROJECT NUMBER <b>21-25</b>
-----------------------	-----------------------------------	--------------------------------

DATE <b>DECEMBER 15, 2022</b>	CHECKED BY <b>ROBIN CLELAND</b>	SHEET NUMBER <b>BIO-02</b>
----------------------------------	------------------------------------	-------------------------------